


NOTE: 11" X 17" SHEETS ARE PRINTED AS HALF-SIZE DRAWINGS AND ARE THEREFORE AT A SCALE WHICH IS DOUBLE THE SCALE SHOWN HEREON.

**Survey Legend**

NOTE: NOT ALL SYMBOLS MAY BE SHOWN ON THIS SURVEY PLAT

⊙	TELEPHONE PEDSTAL	⊙	HANDICAPPED SPACE
⊙	TELEPHONE MANHOLE	⊙	DEED
⊙	TRAFFIC CONTROL BOX	⊙	MEASURED
⊙	TRAFFIC SIGNAL POLE	⊙	PLATTED
⊙	TRAFFIC - PARKING METER	⊙	RECORD
⊙	CABLE TV RISER	⊙	CENTERLINE
⊙	POWER POLE	⊙	FINISHED FLOOR
⊙	LIGHT POLE	⊙	FLOWLINE
⊙	GUY WIRE	⊙	TOP OF ROW
⊙	UTILITY MANHOLE	⊙	TOP OF DRIVE
⊙	ELECTRIC MANHOLE	⊙	ACCESS EASEMENT
⊙	ELECTRIC METER	⊙	UTILITY EASEMENT
⊙	ELECTRIC RISER	⊙	DRAINAGE EASEMENT
⊙	TRANSFORMER	⊙	DRAINAGE & UTILITY EASEMENT
⊙	UTILITY PULL BOX	⊙	BUILDING LINE
⊙	GUARD POST	⊙	EASEMENT
⊙	SON	⊙	LIMITS OF NO ACCESS
⊙	SANITARY SEWER MANHOLE	⊙	RIGHT-OF-WAY
⊙	SANITARY SEWER VALVE	⊙	OKLAHOMA GAS & ELECTRIC CO.
⊙	CLEAN OUT	⊙	OKLAHOMA NATURAL GAS CO.
⊙	DOWNPOUT - ROOF DRAIN	⊙	SOUTHWESTERN BELL TELEPHONE CO.
⊙	STORM SEWER MANHOLE	⊙	CORRUGATED METAL PIPE
⊙	STORM GRATE/INLET	⊙	REINFORCED CONCRETE PIPE
⊙	STORM CURB INLET HOOD	⊙	REINFORCED CONCRETE BOX
⊙	FIRE HYDRANT	⊙	BARB WIRE FENCE
⊙	WATER METER	⊙	CHAIN LINK FENCE
⊙	WATER WELL	⊙	WOOD FENCE
⊙	WATER VALVE	⊙	UNDERGROUND PIPELINE
⊙	GAS VALVE	⊙	UNDERGROUND NATURAL GAS
⊙	GAS METER	⊙	UNDERGROUND TELEPHONE
⊙	GAS SERVICE LINE	⊙	UNDERGROUND ELECTRIC
⊙	PIPELINE MARKER	⊙	UNDERGROUND TRAFFIC SIGNAL
⊙	VENT PIPE	⊙	UNDERGROUND FIBER OPTIC
⊙	MONITORING WELL	⊙	UNDERGROUND CABLE TV
⊙	PISTON RETAKE VALVE	⊙	STORM SEWER
⊙	MAIL BOX	⊙	SANITARY SEWER
⊙	DECIDUOUS TREE	⊙	WATER LINE
⊙	EVERGREEN TREE	⊙	OVERHEAD ELECTRIC
⊙	DEAD TREE	⊙	RAIL ROAD
⊙	BRUSH LINE	⊙	BRUSH LINE
⊙	STAMPED SURVEY CA. 50'P	⊙	STAMPED SURVEY CA. 50'P
⊙	STAMPED SURVEY CA. 50'P	⊙	STAMPED SURVEY CA. 50'P
⊙	OKLAHOMA CERTIFIED CORNER	⊙	OKLAHOMA CERTIFIED CORNER
⊙	RECORD FILED IN THE OFFICE OF THE PUBLIC SHERIFF	⊙	RECORD FILED IN THE OFFICE OF THE PUBLIC SHERIFF

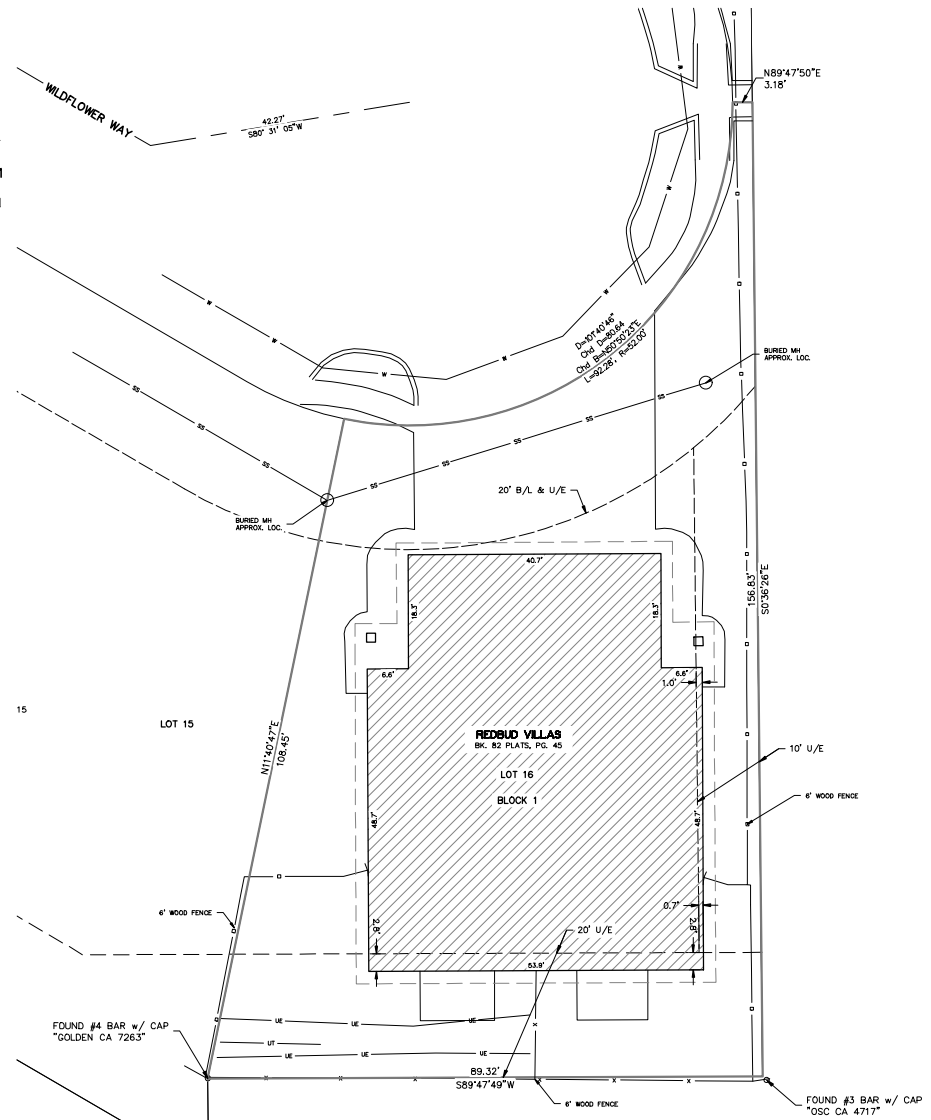

**DURHAM SURVEYING, INC.**  
1800 SOUTH SARA ROAD, YUKON, OK 73089  
Phone (405) 364-0449  
Fax (405) 364-0449  
www.durham-surveying.com

CERTIFICATE OF AUTHORIZATION NO. 0313  
EXPIRATION DATE: JUNE 30, 2020



**REDBUD VILLAS**  
LOT 16, BLOCK 1  
OKLAHOMA CITY, OKLAHOMA CO., OKLAHOMA  
AS-BUILT SURVEY

**REVISIONS**

NO.	DESCRIPTION	DATE
1	12-20-2024	
2	12-20-2024	
3	12-20-2024	
4	12-20-2024	
5	12-20-2024	
6	12-20-2024	
7	12-20-2024	
8	12-20-2024	
9	12-20-2024	
10	12-20-2024	

Proj. No.: 24-120  
Date: 12-20-2024  
Scale: (As Shown)  
Drawn By: [Signature]  
Checked By: [Signature]  
Approved By: [Signature]

**SHEET NUMBER**  
**1**

PART OF LOT 16, BLOCK 1, REDBUD VILLAS,  
OKLAHOMA CITY, CANADIAN CO., OKLAHOMA

EXPIRATION DATE: JUNE 30, 2026