



GENERAL CONTRACTOR

EST. 1973

## CHANGE ORDER REQUEST

<b>Project Name:</b> Bricktown Canal Elevator	<b>Change Order Request (COR):</b> 5
<b>WLM Project Number:</b> 1019	<b>Date:</b> 7/16/2024
<b>General Description:</b> Additional Gutter Pricing	MB-1646

### Scope of Work:

Prices to add additional guttering on the upper walkway edges as requested. The red lines are what was included during bid, the blue was shown to be existing however there was no existing guttering there and the orange is also additional as requested.

This work impacts the project completion date and the substantial completion date should be increased by the number of days requested below.

15 Day(s)

General Contractor Total			357.39
Subcontractor Total			3720.00
Overhead on Work Performed	10%		407.74
Profit on Work Performed	5%		203.87
Total Change Order Cost To Be Insured			4689.00
General Liability Insurance and Bonds			125.15
Subtotal			4814.15
Total Change Order			ADD \$ 4,814

Pricing and Added Time are subject to modification if not approved by:	7/31/2024
--	-----------

Acceptance by an Authorized Representative

W.L. McNatt & Co.

By signing or otherwise giving approval, the total cost change, change in contract time, and change in contract scope will be added to and incorporated as part of the contract documents for the above listed project. W.L. McNatt will only proceed with the work once written authorization to proceed is given.

V.Q4.2023


Subcontractors and Vendors Pricing								
Sub/Vendor Name	QUANTITY	UNIT					UNIT	COST
Stronghold Construction								
Price for additional guttering shown in blue on the below PDF	1	est					2505	2505
Price for additional guttering shown in orange on the below PDF	1	est					1215	1215
W.L. McNatt Pricing								
			MATERIAL		LABOR		SUBCONTRACTOR	
	Qty	Unit	Unit	Cost	Unit	Cost	Unit	Cost
As-Built Drawings	0	hour(s)		0	84.10	0.00		0
Estimating	1	hour(s)		0	98.60	98.60		0
Project Supervision	0	day(s)		0	478.50	0.00		0
Scheduling / Coordination	0	day(s)		0	123.25	0.00		0
Pump Water	0	day(s)		0	239.25	0.00		0
Job Clean Up	0	day		0	268.25	0.00		0
Cleaning Misc. Material	0	sf	0.03	0	0.36	0.00		0
Dumpster (30 yd)	0	each	500	0		0.00		0
Punch List	0	day(s)		0	398.75	0.00		0
Misc. Material	0	sf	0.03	0		0.00		0
Job Trailer	0	month	400	0		0.00		0
Job Storage Container	0	month	150	0		0.00		0
Site Cell Phone	0	week(s)	25	0		0.00		0
Temp. Toilet	0	week(s)	95	0		0.00		0
Temp. Utilities	0	month	350	0		0.00		0
Temp. Construction Fence	0	month	200	0		0.00		0
Builder's Risk Insurance	1	month	118	118		0.00		0
Project Travel	0	miles	0.655	0		0.00		0
Project Equipment	0	day (s)	500	0	290.00	0.00		0
Parking	1	month	120	120	0.00	0.00		0
Labor for setup/removal	0	hour(s)	0	0	36.25	0.00		0
Fuel for generator	0	each	300	0	0.00	0.00		0
Visqueen floor protection	0	each	70	0	0.00	0.00		0
Subtotal				238.00		98.60		3720.00
Material Consumables				17.85				
Taxes				2.94				
Total	4077.39			258.79		98.60		3720.00



V.Q4.2023

**ELEV**  
1/4" = 1'

## 2 | ELEVATOR PLAN - OKLAHOMA AVENUE LEVEL

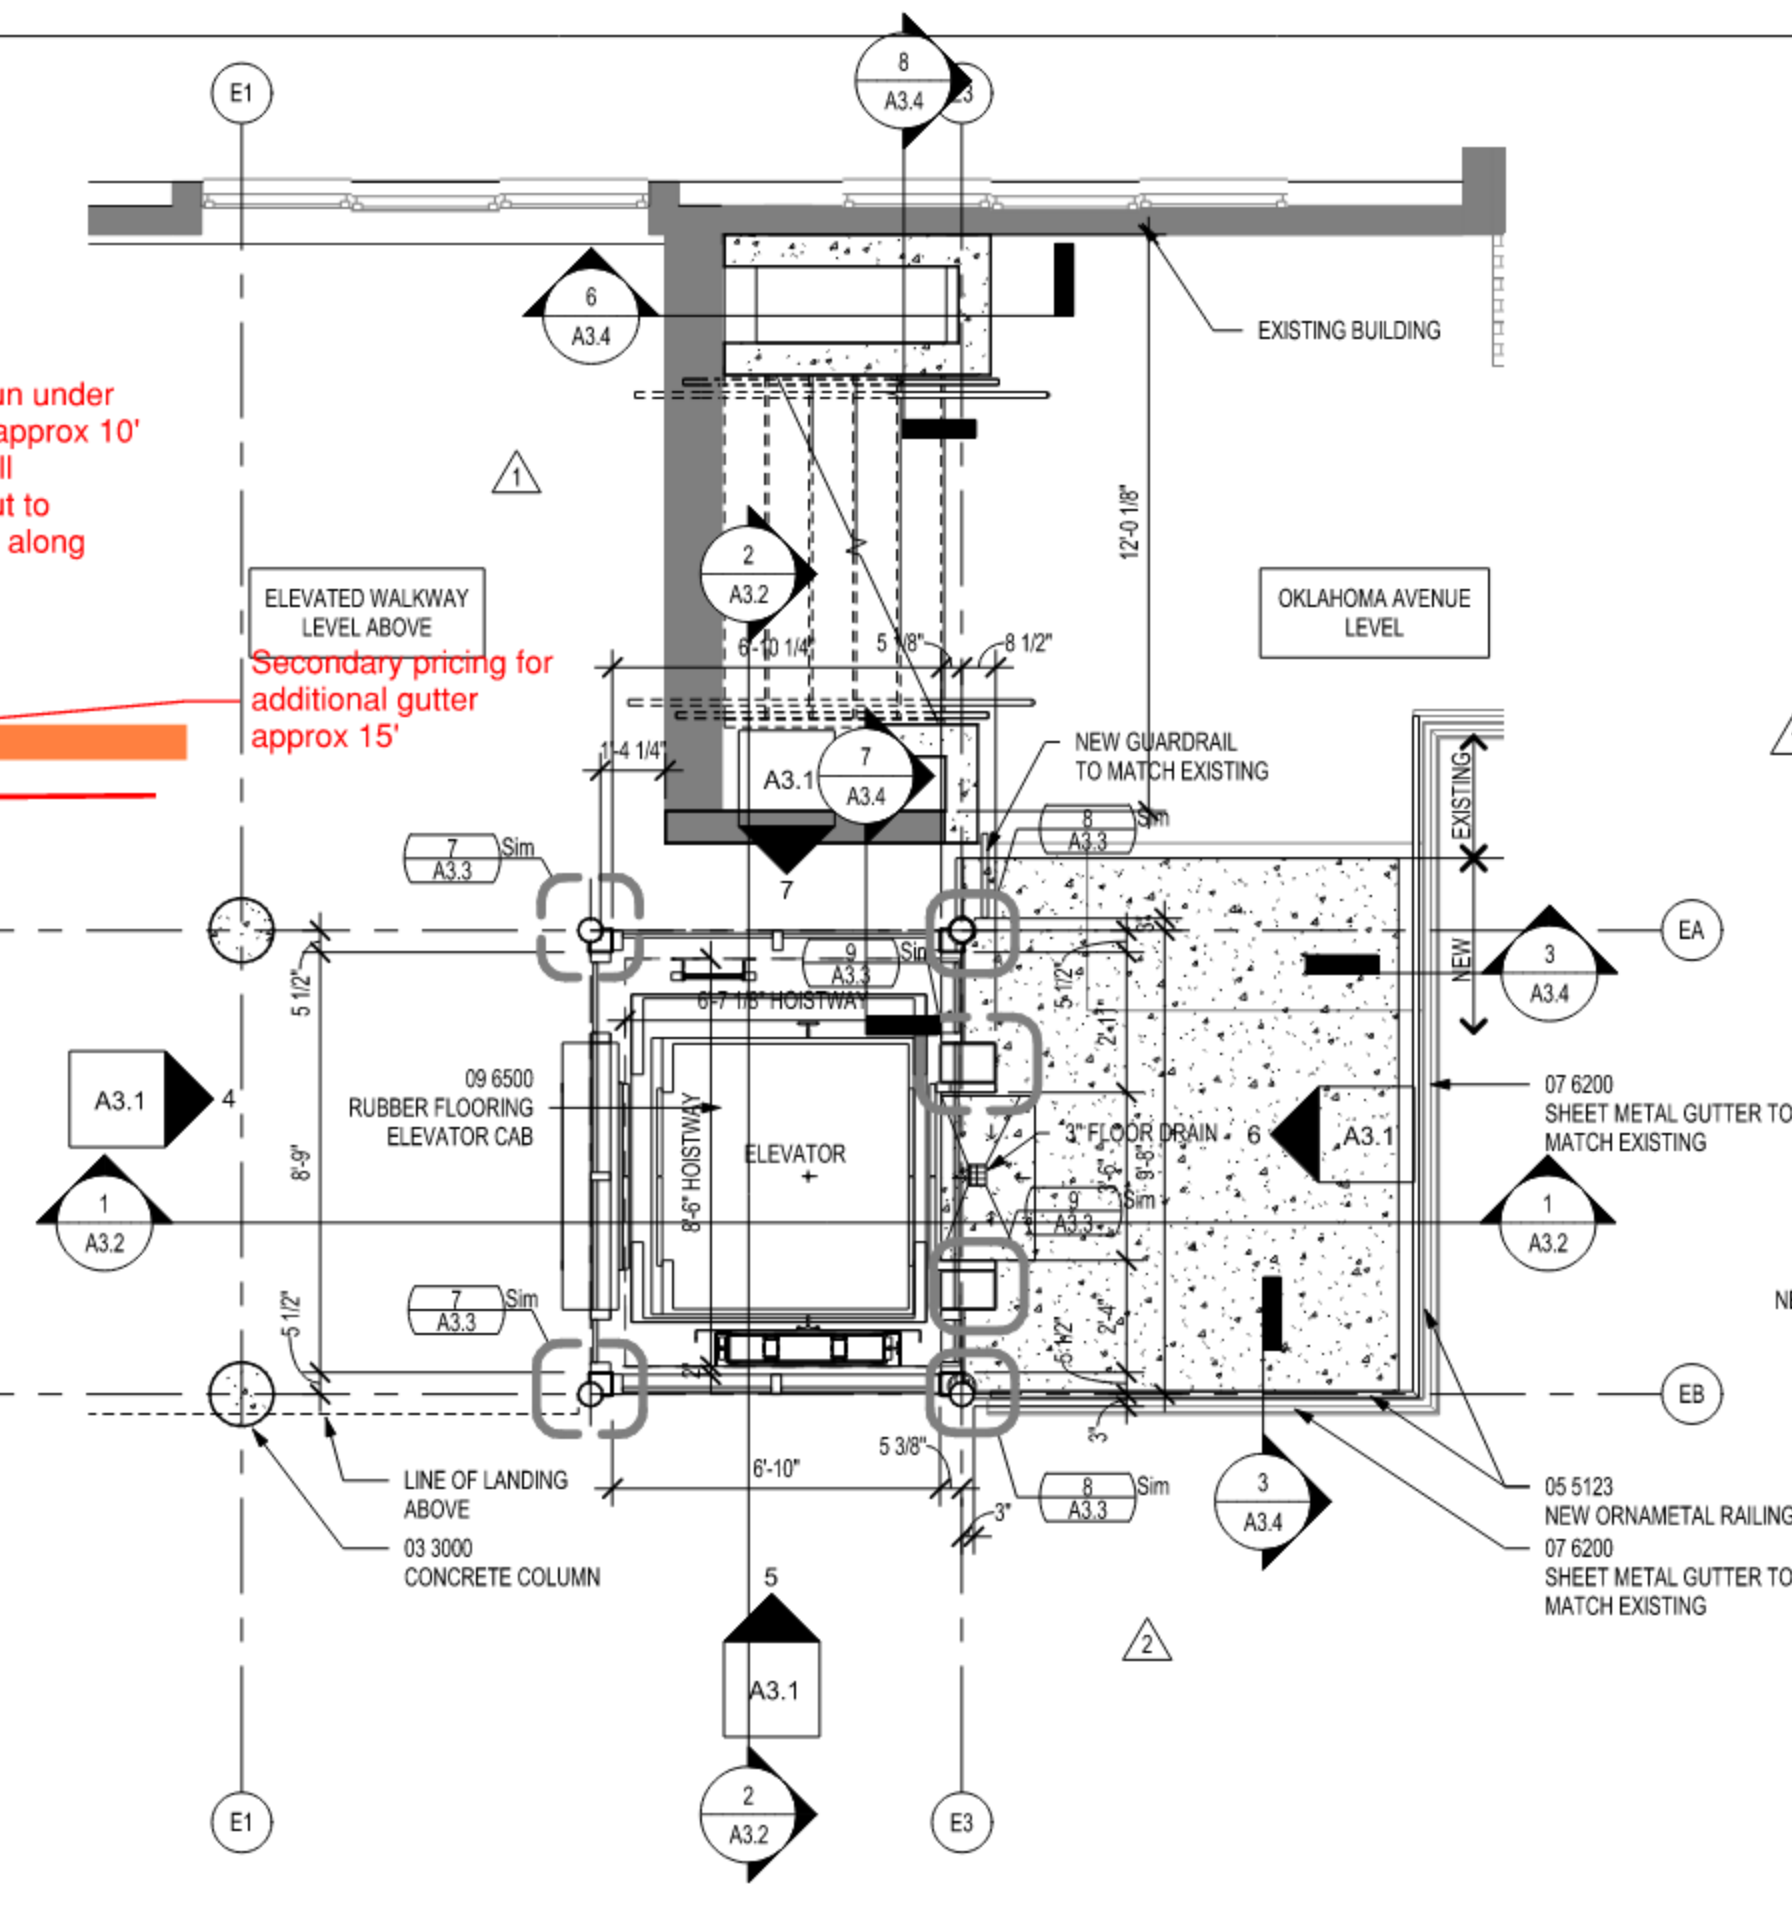

Secondary pricing for additional gutter approx 15'

Tie into existing, no downspout.

# 1 | ELEVATOR PLAN - CANAL LEVEL

$$1/4'' = 1'-0''$$

BRICKTOWN CANAL

